

APPENDIX B

Boring Logs and Well Construction

ECOVA Corporation

Well Installation Log

Client Army Corps of EngineersSite Air Natl. Guard (Task 7)Job Number 801126Field Geologist R.W. GoodfellowDrilling Company Fogle Pump & SupplyBoring Method Air RotaryBorehole Depth 96 FeetWater Depth 36 FeetWell Number MW-5ADate Drilled 4-30-90Coordinates 240023 4591N2452092 2401ECasing Elevation 2390.45Sheet 1 of 2

Depth (Feet)	Blow Counts	Sample No	Recover	Organic Vapor (ppm)	% LEL	% O ₂	General: 50 feet of 6" steel casing, pressure grout.	Graphic Log
							Sample Description	
5				2			SAND (SM) - Fine- to coarse-grained, brown, loose, basalt fragments.	
10							SAND (SM) - Fine- to coarse-grained, dark brown, loose, minor gravel, some wood fragments, damp	
15							WEATHERED BASALT - Gray to brown, dry, loose	
20								
25							SAND (SM) - Fine- to coarse-grained, brown, damp	
30							CLAY WITH SILTY AND SAND (CL) - Brown, semi-plastic, damp.	
35							Static water level at 36 feet.	
40							WEATHERED BASALT - Black, mixed with brown clay, dry. Water yielding zone at 40 feet.	
45							WEATHERED BASALT - Black, water.	
50				1				

801126-A-MW5A

* Background = 2 ppm

ECOVA Corporation

Well Installation Log

Client Army Corps of Engineers

Site Air Natl. Guard (Task 7)

Job Number 801126

Field Geologist R.W. Goodfellow

Drilling Company Fogle Pump & Supply

Boring Method Air Rotary

Borehole Depth 96 Feet

Water Depth 36 Feet

Well Number MW-5A

Date Drilled 4-30-90

Coordinates 240023.4591N

2452092.2401E

Casing Elevation 2390.45

Sheet 2 of 2


Depth (Feet)	Blow Counts	Sample No.	Recover	Organic* Vapor (ppm)	LEL	% O ₂	General: 50 feet of 6" steel casing, pressure grout.	Graphic Log
							Sample Description	
55							WEATHERED BASALT - Orange and black cuttings, water yielding zone at 57 feet.	
60								
65								
70								
75							WEATHERED BASALT	
80								
85								
90								
95							BASALT - Fresh, minor orange cuttings, ~ 30 gpm	
100								

Bottom of Hole - 96 Feet

1990 ECOVA Corporation

801126-A-MW5A

* Background = 2 ppm

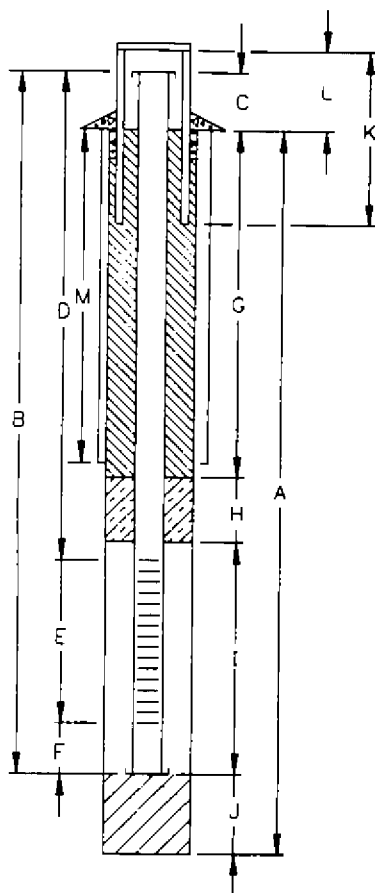WELL COMPLETION MW-5ATOP OF CASING ELEVATION 2380.45'

A BORING DEPTH 96 FT.
 BORING DIAMETER 5 IN.
 B WELL DEPTH 96 FT.
 C WELL STICKUP 0 FT.
 D BLANK INTERVAL 84 FT.
 BLANK DIAMETER 2 IN.
 E SCREEN INTERVAL 81-91 FT.
 SCREEN DIAMETER 2 IN.
 TYPE/SLOT SIZE 0.01
 F SEDIMENT TRAP 3 FT.
 G ANNULAR SEAL 69 FT.
 MATERIAL: GROUT
 H BENTONITE SEAL 5 FT.
 I SANDPACK 19 FT.
 TYPE/SIZE: 20/40
 J BOTOM SEAL/PACK 2 FT.
 MATERIAL: SAND
 K WELL COVER 0 FT.
 L STICKUP 0 FT.
 M CONDUCTOR CASING 51 FT.

NOT TO SCALE

DRILLING TIMES:

START 0745 4/30/90 FINISH 1207 4/30/90

STANDBY or DOWN TIME:

METHOD OF DECON. PRIOR TO DRILLING:

DEVELOPMENT

METHOD OF DEVELOPMENT: DISPLACEMENT PUMPINGPUMP TIME 0830 TIME 1230 DATE 5/29/90PUMPED 4 BARRELS IN 4 HOURS

TURBIDITY X CLEAR MOD TURBID
 AFTER SL. TURBID TURBID
 DEVELOPMENT:

ODOR IN WATER ?

WATER GROUND SURFACE STORAGE TANK
 DISCHARGED STORM SEWERS TANK TRUCK
 TO: 4 DRUMS

DEPTH OF WATER AFTER DEVELOPMENT: 30.5

MATERIALS USED

4 1/2 SACKS of 20/40 SAND
8 SACKS of PORTLAND CEMENT
1 SACKS of PREMIX CONCRETE
1 GALLONS of GROUT USED
1 GROUT COMPOSITION #5 BENTONITE
1 SACKS of BENTONITE PELLETS
1 BUCKETS of BENTONITE PELLETS
1 YARDS CEMENT - SAND USED
4 CENTRALIZERS at 18, 46, 74, AND 92 FEET BGS

WELL COVER USED: X Above Grade
X At Grade
X Other
X Lockable

ECOVA Corporation

Well Installation Log

Client Army Corps of Engineers

Drilling Company Fogle Pump & Supply

Well Number MW-5B

Date Drilled 5-2-90

Site Air Natl Guard (Task 7)

Boring Method Air Rotary

Coordinates 240023 3014 N

Job Number 801126

Borehole Depth 60 Feet

2452104 0267E

Field Geologist R.W. Goodfellow

Water Depth 26 Feet

Casing Elevation 2390.48

Sheet 1 of 2


Depth (Feet)	Blow Counts	Sample No.	Recover	Organic* Vapor (ppm)	Z LEL	% O ₂	General:	Graphic Log
							Sample Description	
5							SAND (SM) - Fine- to coarse-grained, minor basalt pebbles, loose.	
10							SAND WITH GRAVEL (SM) - Fine- to coarse-grained, gravel is composed of basalt chips, brown, loose	
15								
20								
25							<div> <div></div> SILTY CLAY (CL) - Brown, semi-plastic, damp </div> <div> <div></div> Static water level at 26 feet. </div>	
30								
35								
40							BASALT - Fresh, damp	
45								
50							WEATHERED BASALT.	

1990 ECOVA Corporation

801126-A-MW5B

* Background = 2 ppm

* Background = 2 ppm

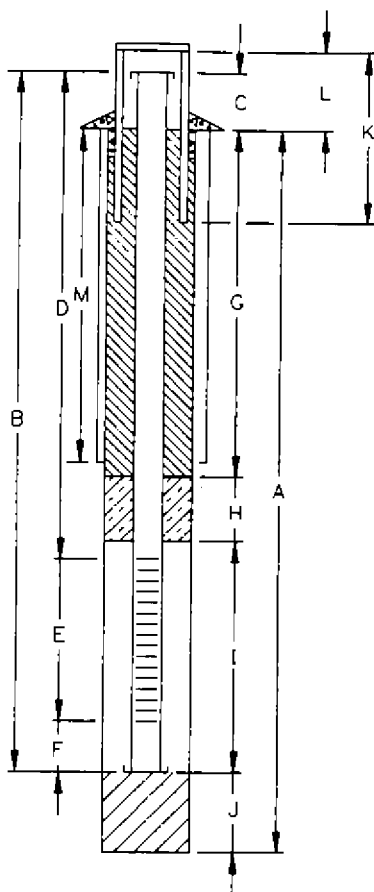WELL COMPLETION MW-5BTOP OF CASING ELEVATION 2390.48'

A BORING DEPTH 60 FT.
 BORING DIAMETER 6 IN.
 B WELL DEPTH 60 FT.
 C WELL STICKUP 0 FT.
 D BLANK INTERVAL 26 FT.
 BLANK DIAMETER 2 IN.
 E SCREEN INTERVAL 23-43 FT.
 SCREEN DIAMETER 2 IN.
 TYPE/SLOT SIZE 0.01
 F SEDIMENT TRAP 14 FT.
 G ANNULAR SEAL 14 FT.
 MATERIAL: GROUT
 H. BENTONITE SEAL 3 FT.
 I SANDPACK 40 FT.
 TYPE/SIZE: 20/40
 J BOTTOM SEAL/PACK 3 FT.
 MATERIAL: SAND
 K WELL COVER 0 FT.
 L STICKUP 0 FT.
 M CONDUCTOR CASING FT.

NOT TO SCALE

DRILLING TIMES:

START 1340 5/2/90 FINISH 5/2/90

STANDBY or DOWN TIME:

METHOD OF DECON PRIOR TO DRILLING.

DEVELOPMENT

METHOD OF DEVELOPMENT

PUMP TIME 0730 TO 1230 DATE 5/25/90

TURBIDITY CLEAR MOD. TURBID
 AFTER
 DEVELOPMENT: X SL. TURBID TURBID

ODOR IN WATER ?


WATER GROUND SURFACE STORAGE TANK
 DISCHARGED STORM SEWERS TANK TRUCK
 TO: 4 DRUMS

DEPTH OF WATER AFTER DEVELOPMENT 29'

MATERIALS USED

4 1/2 SACKS of 20/40 SAND
6 SACKS of PORTLAND CEMENT
 SACKS of PREMIX CONCRETE
 GALLONS of GROUT USED
 GROUT COMPOSITION #6 BENTONITE
1 1/2 SACKS of BENTONITE PELLETS
 BUCKETS of BENTONITE PELLETS
 YARDS CEMENT - SAND USED
2 CENTRALIZERS at TOP AND BOTTOM SCREEN BGS

WELL COVER USED: Above Grade
X At Grade
 Other
X Lockable

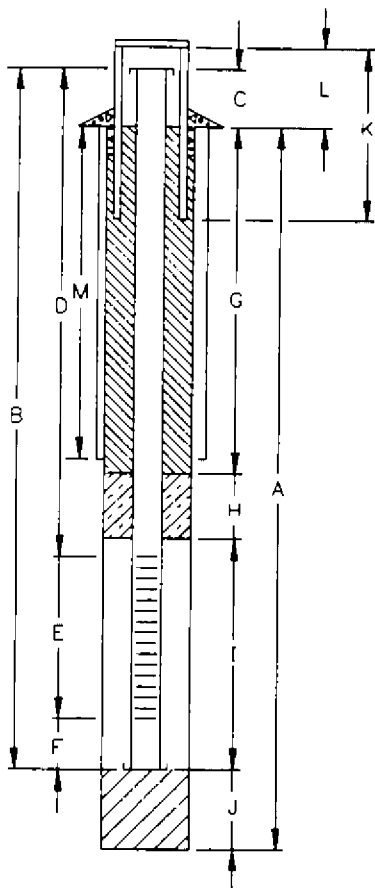WELL COMPLETION MW-7BTOP OF CASING ELEVATION 2380.08'

A BORING DEPTH 43 FT.
 BORING DIAMETER 6 IN.
 B WELL DEPTH 35 FT.
 C WELL STICKUP 0 FT.
 D BLANK INTERVAL 14 FT.
 BLANK DIAMETER 2 IN.
 E SCREEN INTERVAL 7.5-27.5 FT.
 SCREEN DIAMETER 2 IN.
 TYPE/SLOT SIZE 0.01
 F SEDIMENT TRAP 2 FT.
 G ANNULAR SEAL 0 FT.
 MATERIAL
 H BENTONITE SEAL 3 FT.
 I SANDPACK 23.6" FT.
 TYPE/SIZE: 20/40
 J BOTOM SEAL/PACK 1.6" FT.
 MATERIAL SAND
 K WELL COVER 0 FT.
 L STICKUP 0 FT.
 M CONDUCTOR CASING FT.

NOT TO SCALE

DRILLING TIMES:

START 1100 4/18/90 FINISH 1530 4/18/90

STANDBY or DOWN TIME:

 DRILLING SLOW DUE TO CLAY ENCOUNTERED IN BORING
 CLAY PLUGGED UP DELIVERY PIPE TO CYCLONE.

METHOD OF DECON. PRIOR TO DRILLING:

DEVELOPMENT

METHOD OF DEVELOPMENT:

PUMP TIME 1100 TO 1500 DATE 5/23/90

TURBIDITY CLEAR MOD. TURBID
 AFTER
 DEVELOPMENT: SL. TURBID X TURBID

ODOR IN WATER ?

WATER GROUND SURFACE STORAGE TANK
 DISCHARGED STORM SEWERS TANK TRUCK
 TO: X DRUMS

DEPTH OF WATER AFTER DEVELOPMENT 18.0

MATERIALS USED

7 SACKS of 20/40 SAND
 SACKS of
 SACKS of PREMIX CONCRETE
 GALLONS of GROUT USED
 GROUT COMPOSITION
1 SACK of BENTONITE PELLETS
 BUCKETS of BENTONITE PELLETS
 YARDS CEMENT - SAND USED
2 CENTRALIZERS at TOP AND BOTTOM OF SCREEN BGS

WELL COVER USED: Above Grade
 X At Grade
 Other
 X Lockable

ECOVA Corporation

Well Installation Log

Client Army Corps of EngineersDrilling Company Fogle Pump & SupplyWell Number MW-7BDate Drilled 4-18-90Site Air Natl. Guard (Task 7)Boring Method Air RotaryCoordinates 240753.7185 N2452205.5566 EJob Number 801126Borehole Depth 43 FeetCasing Elevation 2380.08Field Geologist K. MayWater Depth 18.0 FeetSheet 1 of 1

Depth (Feet)	Blow Counts	Sample No.	Recover	Organic + Vapor (ppm)	* LEL	N ₂ O ₂	General: 24 feet of 6" steel casing.	Graphic Log
							Sample Description	
5				1.0			SAND WITH GRAVEL (SM) - Medium- to coarse-grained, brown, minor black basalt chips, loose At 6 feet encountered boulder, pulled 8 feet of casing and set 20 foot length.	
10								
15							SAND, SILT, AND GRAVEL (BASALT) - Loose, trace amount of gravel with granitic(?) composition ▽ Static water level at 18 feet.	
20							≡ SAND (SM) - Coarse-grained, dark gray, loose, wet, petroleum odor.	
25				20			WEATHERED BASALT(?) - Reddish brown, more water.	
30				15			Reddish brown, moist	
35							BASALT.	
40								
45							Bottom of Hole - 43 Feet	
50								

1990 ECOVA Corporation

801126-A-MW7B

* Background = 1.0 ppm

ECOVA Corporation Well Installation Log							Well Number <u>MW-8A</u> Date Drilled <u>3/26/90</u> <u>4/27/90</u>
Client <u>Army Corps of Engineers</u>			Drilling Company <u>Eagle Pump & Supply</u>		Coordinates <u>340632 6323N</u>		
Site <u>Air Natl Guard (Task 7)</u>			Boring Method <u>Air Rotary</u>		Coordinates <u>2452389 1722E</u>		
Job Number <u>801126</u>			Borehole Depth <u>86 Feet</u>		Casing Elevation <u>2379.73</u>		
Field Geologist <u>R.W. Goodfellow</u>			Water Depth <u>19 Feet</u>		Sheet <u>1</u> of <u>2</u>		

Depth (Feet)	Blow Counts	Sample No	Recover	Organic Vapor (ppm)	% LEL	% O ₂	General: <u>48 feet of 6" casing</u>	Sample Description	Graphic Log
5							SAND (SM) - Fine- to coarse-grained, brown, loose, minor basalt fragments, dry		
10									
15								SILTY CLAY (ML) - Brown, loose, with coarse basalt sand.	
20								∇ Static water level at 19 feet Same as above.	
25							BASALT - Moderately fresh, dry.		
30									
35								Same as above, damp.	
40									
45							BASALT - Wet.		
50				0.0					

801126-A-MW8A

Background = 5.0 ppm

1990 ECOVA Corporation

ECOVA Corporation

Well Installation Log

Client Army Corps of Engineers

Site Air Natl Guard (Task 7)

Job Number 801126

Field Geologist R.W. Goodfellow

Drilling Company Fogle Pump & Supply

Boring Method Air Rotary

Borehole Depth 86 Feet

Water Depth 19 Feet

Fogle Pump & Supply

Air Rotary

86 Feet

19 Feet

Well Number 41W-8A

Date Drilled 4/26/90

Coordinates 240632.6323N

2452389.1722E


Casing Elevation 2378.73

Sheet 2 of 2

Depth (Feet)	Blow Counts	Sample No	Recover	Organic Vapor (ppm)	% LEL	% O ₂	General: 48 feet of 6" casing	Graphic Log
							Sample Description	
55							Water yielding zone at 57 feet.	
60								
65							BASALT - Fresh, water flow ~ 50 gpm	
70								
75							BASALT - Minor orange mottling, water flow ~50 gpm	
80							Same as above.	
85							Bottom of Hole - 86 Feet	
90								
95								
100								

801126-A-MWBA

* Background = _____ppm

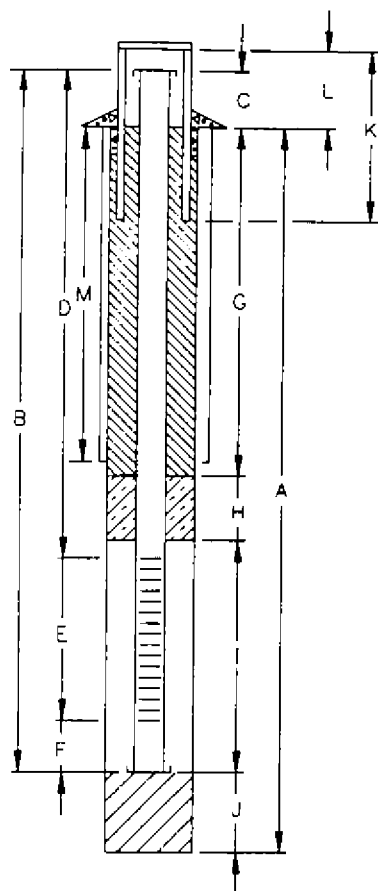WELL COMPLETION MW-8ATOP OF CASING ELEVATION 2378.73'

A BORING DEPTH 86 FT.
 BORING DIAMETER 6 IN.
 B WELL DEPTH 85'6" FT.
 C WELL STICKUP 0 FT.
 D BLANK INTERVAL 70 FT.
 BLANK DIAMETER 2 IN.
 E SCREEN INTERVAL 66.5-76.5 FT.
 SCREEN DIAMETER 2 IN.
 TYPE/SLOT SIZE 0.01
 F SEDIMENT TRAP 5 FT.
 G ANNULAR SEAL 54 FT.
 MATERIAL GROUT
 H BENTONITE SEAL 5'6" FT.
 I SANDPACK 22'6" FT.
 TYPE/SIZE: 20/40
 J BOTTOM SEAL/PACK 3' FT.
 MATERIAL SAND
 K WELL COVER FT.
 L STICKUP 0 FT.
 M CONDUCTOR CASING 48 FT.

NOT TO SCALE

DRILLING TIMES:

START 1440 4/25/90 FINISH 1025 4/27/90

STANDBY or DOWN TIME:

METHOD OF DECON PRIOR TO DRILLING:

DEVELOPMENT

METHOD OF DEVELOPMENT

PUMP TIME 0800 TO 1200 DATE 5/24/90PUMPED 6 BARRELS IN 4 HOURS.

TURBIDITY X CLEAR MOD. TURBID
 AFTER SL. TURBID TURBID
 DEVELOPMENT:

ODOR IN WATER ?

WATER GROUND SURFACE STORAGE TANK
 DISCHARGED STORM SEWERS TANK TRUCK
 TO: X DRUMS

DEPTH OF WATER AFTER DEVELOPMENT: 20.0'

MATERIALS USED

4 SACKS of 20/40 SAND
8 SACKS of PORTLAND CEMENT
 SACKS of PREMIX CONCRETE
 GALLONS of GROUT USED
 GROUT COMPOSITION #6 BENTONITE
1 SACKS of BENTONITE PELLETS
 BUCKETS of BENTONITE PELLETS
 YARDS CEMENT - SAND USED
4 CENTRALIZERS EVERY 25' BGS

WELL COVER USED: Above Grade
 X At Grade
 Other
 X Lockable

RESOURCE PROTECTION WELL REPORT


START CARD NO. 77709PROJECT NAME: SPOKANE AIRPORT BURN PITWELL IDENTIFICATION NO. MW13ADRILLING METHOD: 1 1/4" HOLLOW STEM AUGER # AIR ROTARYDRILLER: WILL HAYES (2035)FIRM: RUEN DRILLING, INC. (RUEN CDI 1750M)


SIGNATURE: _____

CONSULTING FIRM: LANDAU ASSOCIATES INC.REPRESENTATIVE: DEB SUNELL

County _____

LOCATION: T 24N, R 42E, SEC. 6 1/4 NE 1/4 NEDISTANCE: (W) 112 FT. FROM N/S SECTION LINE(S) 450 FT. FROM E/W SECTION LINEDATUM: USGS MONUMENT 250' SOUTH OF RUNWAYWATER LEVEL ELEVATION: (23') 2,357.1'INSTALLED: 12/18/92DEVELOPED: 12/22/92

AS-BUILT	WELL DATA	FORMATION DESCRIPTION
See attached sheet	GM	Dark brown silty to sandy GRAVEL (med. dense, moist) 5
	SW	Dark brown gravelly medium to very coarse SAND (loose, moist) 10
	GM	Dark brown silty sandy GRAVEL (loose, moist) 15
	ML	Medium brown fine sandy SILT with trace charcoal and leaves (very stiff, damp) 20
		25
 RUEN DRILLING, INC. BOX 267 CLARK FORK, ID 83811 (208) 266-1151	BASALT TO 42'	Weathered Basalt with small angular pebbles mixed with clay 30
		35

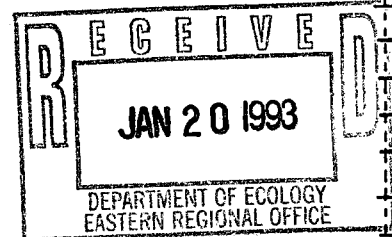SCALE: 1" = 5'PAGE 1 OF 2

END OF HOLE 42'

LANDAU ASSOCIATES, INC.
Edmonds, WA (206) 778-0907 FAX (206) 778-6409

As-built Well Completion Form



Project: SPOKANE AIRPORT BURNPIT
Project No.: 207001.33
Well(s) No.: MW 13 A
Drilling Co.: BUEN DRILLING INC
Installation Start Date: 12/18/92 Hour: 1000
Installation Finish Date: 12/22/92 Hour: 1000 manual
Well Type: ☒ Single ☐ Nested ☐ Clustered

WATER DISCHARGE MONITORING			
Date:	Time:	PID(ppm)	
Date:	Time:	PID(ppm)	
EQUIPMENT USED	
<input checked="" type="checkbox"/> Hollow Stem Auger	<u>4 1/4"</u>
<input type="checkbox"/> Cable Tool	
<input type="checkbox"/> Air Rotary	
<input type="checkbox"/> Other	

MATERIALS USED	
<u>2</u> Sacks of	<u>10 - 20</u> Sand
<u> </u> Sacks of	<u> </u> Concrete/Cement
<u>3</u> Sacks of	<u> </u> Grout Mix Used
<u>17</u> Sacks of	<u>20#</u> Bentonite <u>Chips</u>
<u> </u> Pounds of	<u> </u> Bentonite Pellets/Chips
<u>40</u> Feet of	<u> </u> Inch PVC Blank Casing
<u>10</u> Feet of	<u> </u> Inch PVC Slotted Screen
<u> </u> Feet of	<u> </u> Inch PVC Slotted Screen
<u> </u> Feet of	<u> </u> Inch PVC Slotted Screen

DEVELOPMENT			
Method of Development: <u>BAILER 1 1/2" SS</u>			
Begin Date:	<u>12/21/92</u>	Time:	<u>0800 BAIL 25 GALLONS</u>
Finish Date:	<u>12/22/92</u>	Time:	<u>1330 (≈ 106 GALLONS)</u>
Yield:	Time From:	To:	Date:
Estimate of Total Water Removed During Development: <u>35</u> <u>Gallons</u>			
Description of Turbidity at End of Development:	<input type="checkbox"/> Clear	<input checked="" type="checkbox"/> Slightly Cloudy	
	<input type="checkbox"/> Mod. Turbid	<input type="checkbox"/> Very Cloudy	
Odor of Water:	<u>NONE</u>		
Water Discharged To:	<u>GROUND</u>		
Depth to Water After Development:	<u>23.0</u>	<u>Feet</u>	

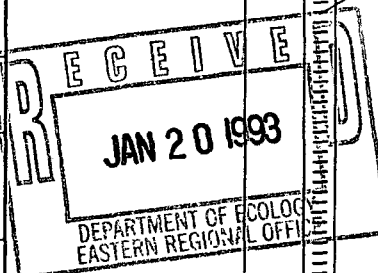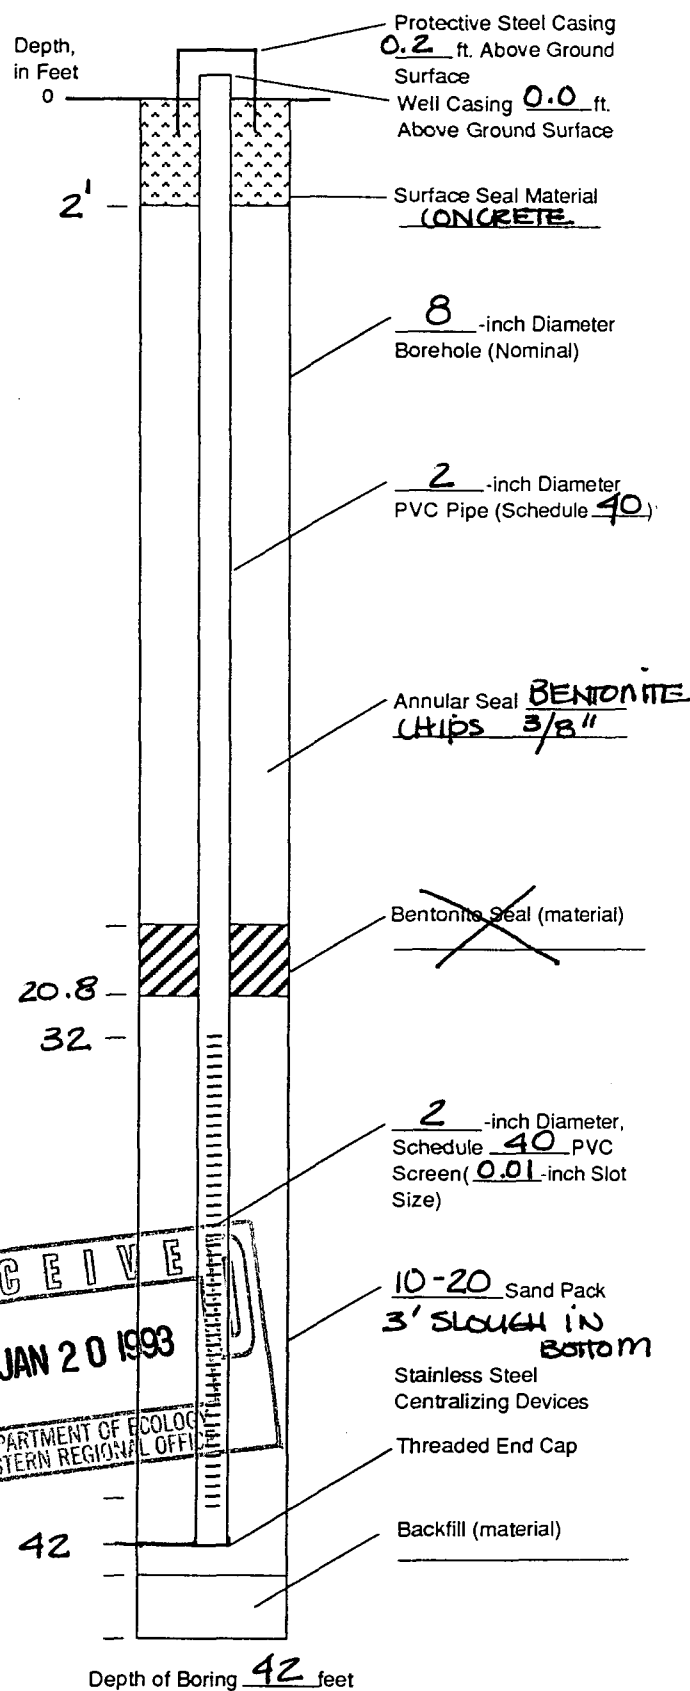



RESOURCE PROTECTION WELL REPORT

START CARD NO. 57709PROJECT NAME: SPOKANE AIRPORT BURNPITWELL IDENTIFICATION NO. MW13BDRILLING METHOD: 4 1/4" HOLLOW STEM AUGERDRILLER: WILL HAYES (203F)FIRM: RUEN DRILLING (RUENCDI 175 QM)

SIGNATURE: _____

CONSULTING FIRM: LANDAU ASSOCIATES INC.REPRESENTATIVE: DEB SUNELLCounty _____
LOCATION: T 24N, R 42E, SEC. 6 1/4 NE 1/4 NEDISTANCE: (W) 112 FT. FROM N/S SECTION LINE(S) 450 FT. FROM E/W SECTION LINEDATUM: USGS MONUMENT 250' SOUTH OF RUNWAYWATER LEVEL ELEVATION: (14.7) 2,366.7'INSTALLED: ~~12/17/92~~ 12/17/92DEVELOPED: 12/21/92

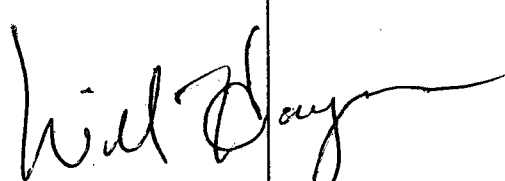AS-BUILT	WELL DATA	FORMATION DESCRIPTION
See attached sheet	GM	DARK brown silty to sandy GRAVEL (med. dense, moist) 5.0
	SW	Dark brown gravelly medium to very coarse SAND (loose, moist) 10.0
	GM	Dark brown silty sandy GRAVEL (loose, moist) 15.0
	ML	Medium brown fine sandy SILT w/ trace charcoal and leaves (very stiff damp) 20.0
		END OF HOLE 20 FT.
 RUEN DRILLING, INC. BOX 267 CLARK FORK, ID 83811 (208) 266-1151		29.0
		30.0
		35.0

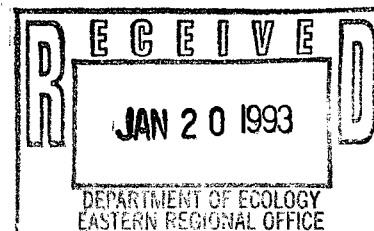SCALE: 1" = 5'PAGE 1 OF 2

LANGAU ASSOCIATES, INC.
Edmonds, WA (206) 778-0907 FAX (206) 778-6409

As-built Well Completion Form



Project: SPOKANE AIRPORT BURNPIT
Project No.: 207001.33
Well(s) No.: MW 13 B
Drilling Co.: BURN DRILLING INC.
Installation Start Date: 12/17/92 Hour: _____
Installation Finish Date: 12/22/92 Hour: _____
Well Type: ☒ Single ☐ Nested ☐ Clustered

WATER DISCHARGE MONITORING			
Date: _____	Time: _____	PID(ppm) _____	
Date: _____	Time: _____	PID(ppm) _____	
EQUIPMENT USED	
<input type="checkbox"/>	Hollow Stem Auger
<input type="checkbox"/>	Cable Tool
<input type="checkbox"/>	Air Rotary
<input type="checkbox"/>	Other _____

MATERIALS USED	
<u>4.7</u>	Sacks of <u>10-20</u> Sand
<u>2</u>	Sacks of _____ Concrete/Cement
_____	Sacks of _____ Grout Mix Used
<u>2</u>	Sacks of <u>Power</u> Bentonite <u>Chips</u>
_____	Pounds of Bentonite Pellets/Chips
<u>10</u>	Feet of _____ Inch PVC Blank Casing
<u>10</u>	Feet of _____ Inch PVC Slotted Screen
_____	_____
_____	_____

DEVELOPMENT			
Method of Development: <u>HONDA PUMP</u>			
Begin Date: <u>12/18/92</u>	Time: <u>PURGE 25 Gall</u>		
Finish Date: <u>12/21/92</u>	Time: <u>PURGE 10 GAL.</u>		
Yield: _____	Time From: _____	To: _____	Date: _____
Estimate of Total Water Removed During Development: <u>35</u> Gallons			
Description of Turbidity at End of Development:	<input type="checkbox"/>	Clear	<input checked="" type="checkbox"/> Slightly Cloudy
	<input type="checkbox"/>	Mod. Turbid	<input type="checkbox"/> Very Cloudy
Odor of Water: <u>NONE</u>			
Water Discharged To: <u>GROUND</u>			
Depth to Water After Development: <u>14.7</u> Feet			

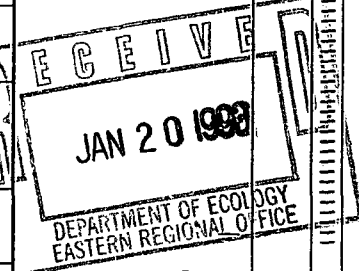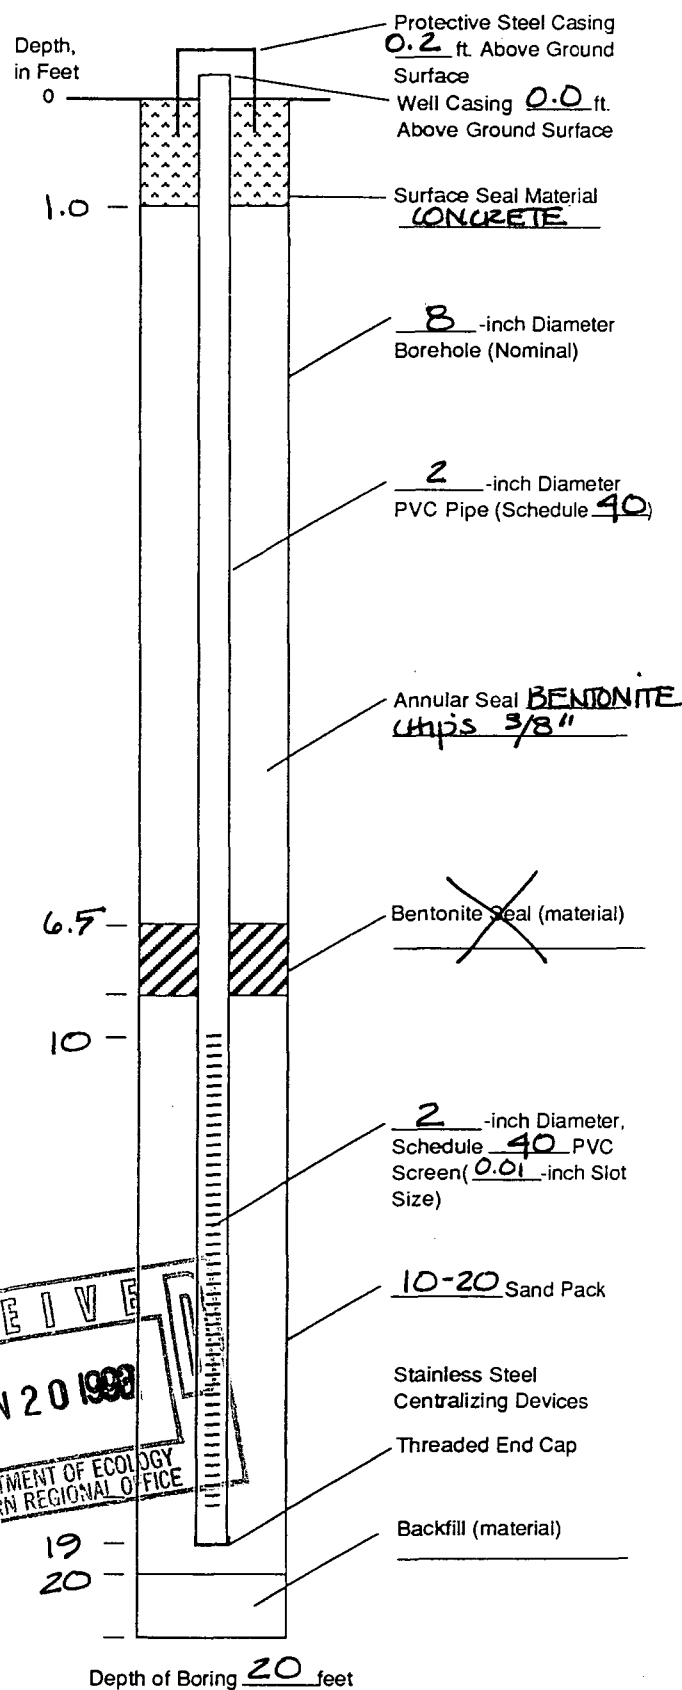

RESOURCE PROTECTION WELL REPORT

START CARD NO. 97709PROJECT NAME: SPOKANE AIRPORT BURNPITWELL IDENTIFICATION NO. MAW14ADRILLING METHOD: 4 1/4" HOLLOW STEM AUGER & AIR ROTARYDRILLER: WILL HAYES (2035)FIRM: RUEN DRILLING (RUENCDI 175 PM)


SIGNATURE: _____

CONSULTING FIRM: LANDAU ASSOCIATES INC.REPRESENTATIVE: DEB SUNNELL


County _____

LOCATION: T 24 N, R 42 E, SEC. 6 1/4 NE 1/4 NEDISTANCE: (W) 165 FT. FROM N/S SECTION LINE(S) 555 FT. FROM E/W SECTION LINEDATUM: USGS MONUMENT 250' SOUTH OF RUNWAYWATER LEVEL ELEVATION: N/AINSTALLED: 12/22/92DEVELOPED: NOT YET

AS-BUILT	WELL DATA	FORMATION DESCRIPTION
See attached sheet	SW	Brown to Grey silty and fine to coarse SAND with trace Gravel (loose, moist)
	CL	Red-brown CLAY with trace Gravel (stiff, wet)
	SW	Dark Grey medium to coarse SAND with Gravel (medium dense, wet)
	CL	Brown CLAY with trace Gravel to brown sandy CLAY with silt and trace Organics (stiff, wet)
	CL/ML	Light brown sandy silty CLAY to clayey sandy SILT (stiff, moist)
	BASALT	

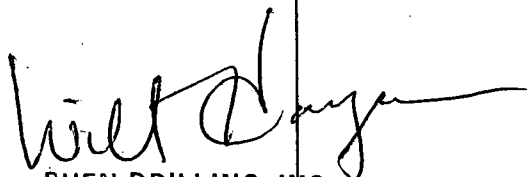

RUEN DRILLING, INC.
BOX 267
CLARK FORK, ID 83811
(203) 266-1151

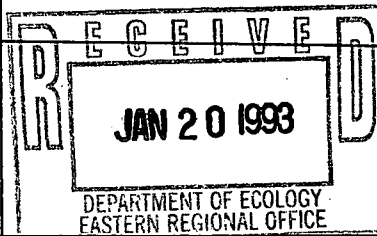SCALE: 1" = 5'PAGE 1 OF 2

END OF HOLE 35'

LANDAU ASSOCIATES, INC.
Edmonds, WA (206) 778-0907 FAX (206) 778-6409

As-built Well Completion Form

Project: SAS - BURN PIT
Project No.: 207001.33
Well(s) No.: MW 14A
Drilling Co.: BURN DRILLING INC.
Installation Start Date: 12/22/92 Hour: 1000
Installation Finish Date: 12/22/92 Hour: 1330
Well Type: ☒ Single ☐ Nested ☐ Clustered

WATER DISCHARGE MONITORING

Date: _____ Time: _____ PID(ppm) _____
Date: _____ Time: _____ PID(ppm) _____
EQUIPMENT USED

☒ Hollow Stem Auger 4 1/4"
☐ Cable Tool
☐ Air Rotary
☐ Other _____

MATERIALS USED

45 Sacks of 10 - 20 Sand
2 Sacks of _____ Concrete/Cement
_____ Sacks of _____ Grout Mix Used
49 Sacks of Powdered Bentonite chips
_____ Pounds of Bentonite Pellets/Chips
25 Feet of 2" Inch PVC Blank Casing
10 Feet of 2" Inch PVC Slotted Screen

DEVELOPMENT

Method of Development:

Begin Date: _____ Time: _____

Finish Date: _____ Time: _____

Yield: _____ Time From: _____ To: _____ Date: _____

Estimate of Total Water Removed During Development:


Gallons

Description of Turbidity at End of Development: ☐ Clear ☐ Slightly Cloudy
☐ Mod. Turbid ☐ Very Cloudy

Odor of Water: NONE

Water Discharged To: _____

Depth to Water After Development: _____ Feet

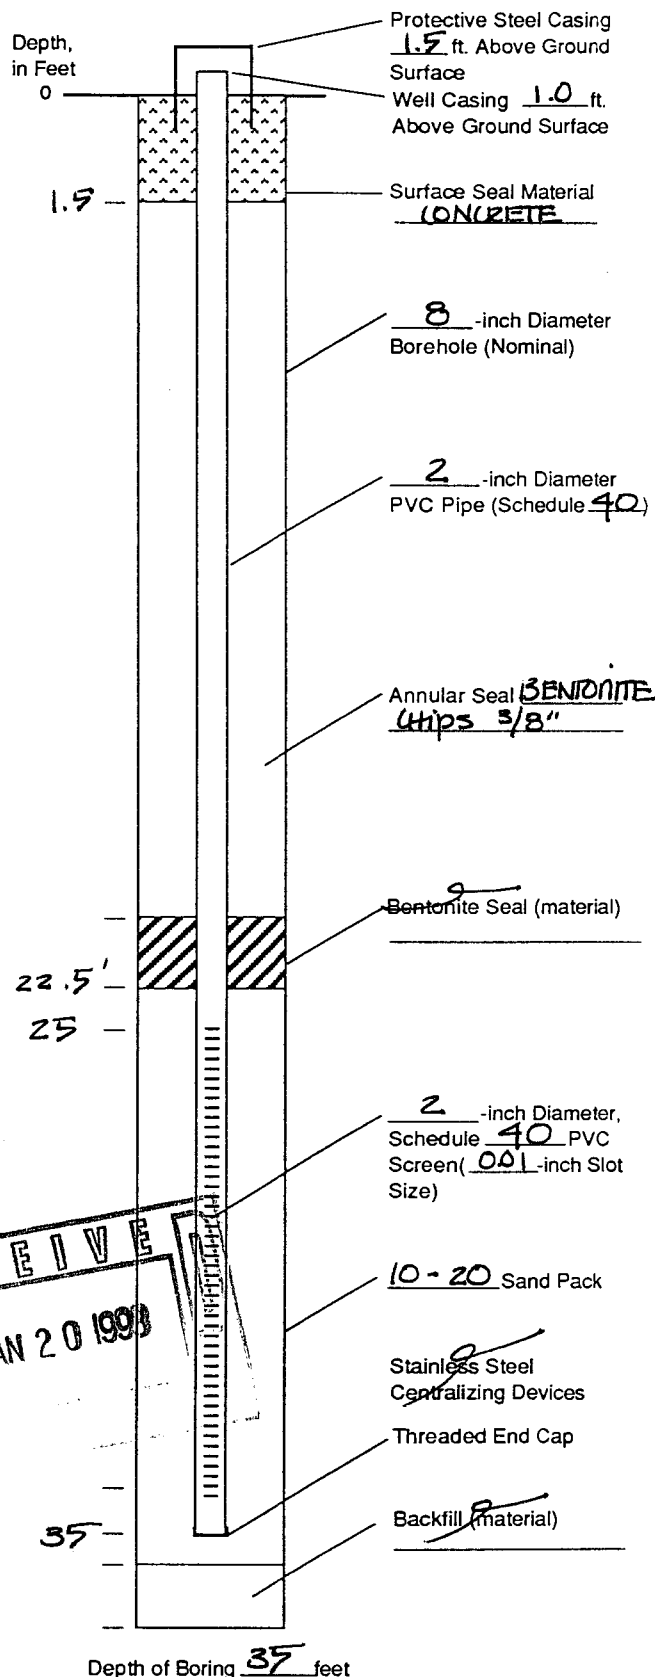


RESOURCE PROTECTION WELL REPORT

START CARD NO. 57709

PROJECT NAME: SPOKANE AIRPORT BURNPIT
 WELL IDENTIFICATION NO. MW 14B
 DRILLING METHOD: 4 1/4" HOLLOW STEM AUGER
 DRILLER: WILL HAYES (2039)
 FIRM: RUEN DRILLING (RUENCDI 175 QM)
 SIGNATURE: _____
 CONSULTING FIRM: LANDAU ASSOCIATES INC.
 REPRESENTATIVE: DEB SUTNELL

County
 LOCATION: T 24N, R 42E, SEC. 6 1/4 NE 1/4 NE
 DISTANCE: (W) 165 FT. FROM N/S SECTION LINE
 (S) 557 FT. FROM E/W SECTION LINE
 DATUM: USGS MONUMENT 250' SOUTH OF RUNWAY
 WATER LEVEL ELEVATION: (18.5) 2,362.9
 INSTALLED: 12/21/92
 DEVELOPED: 12/22/92

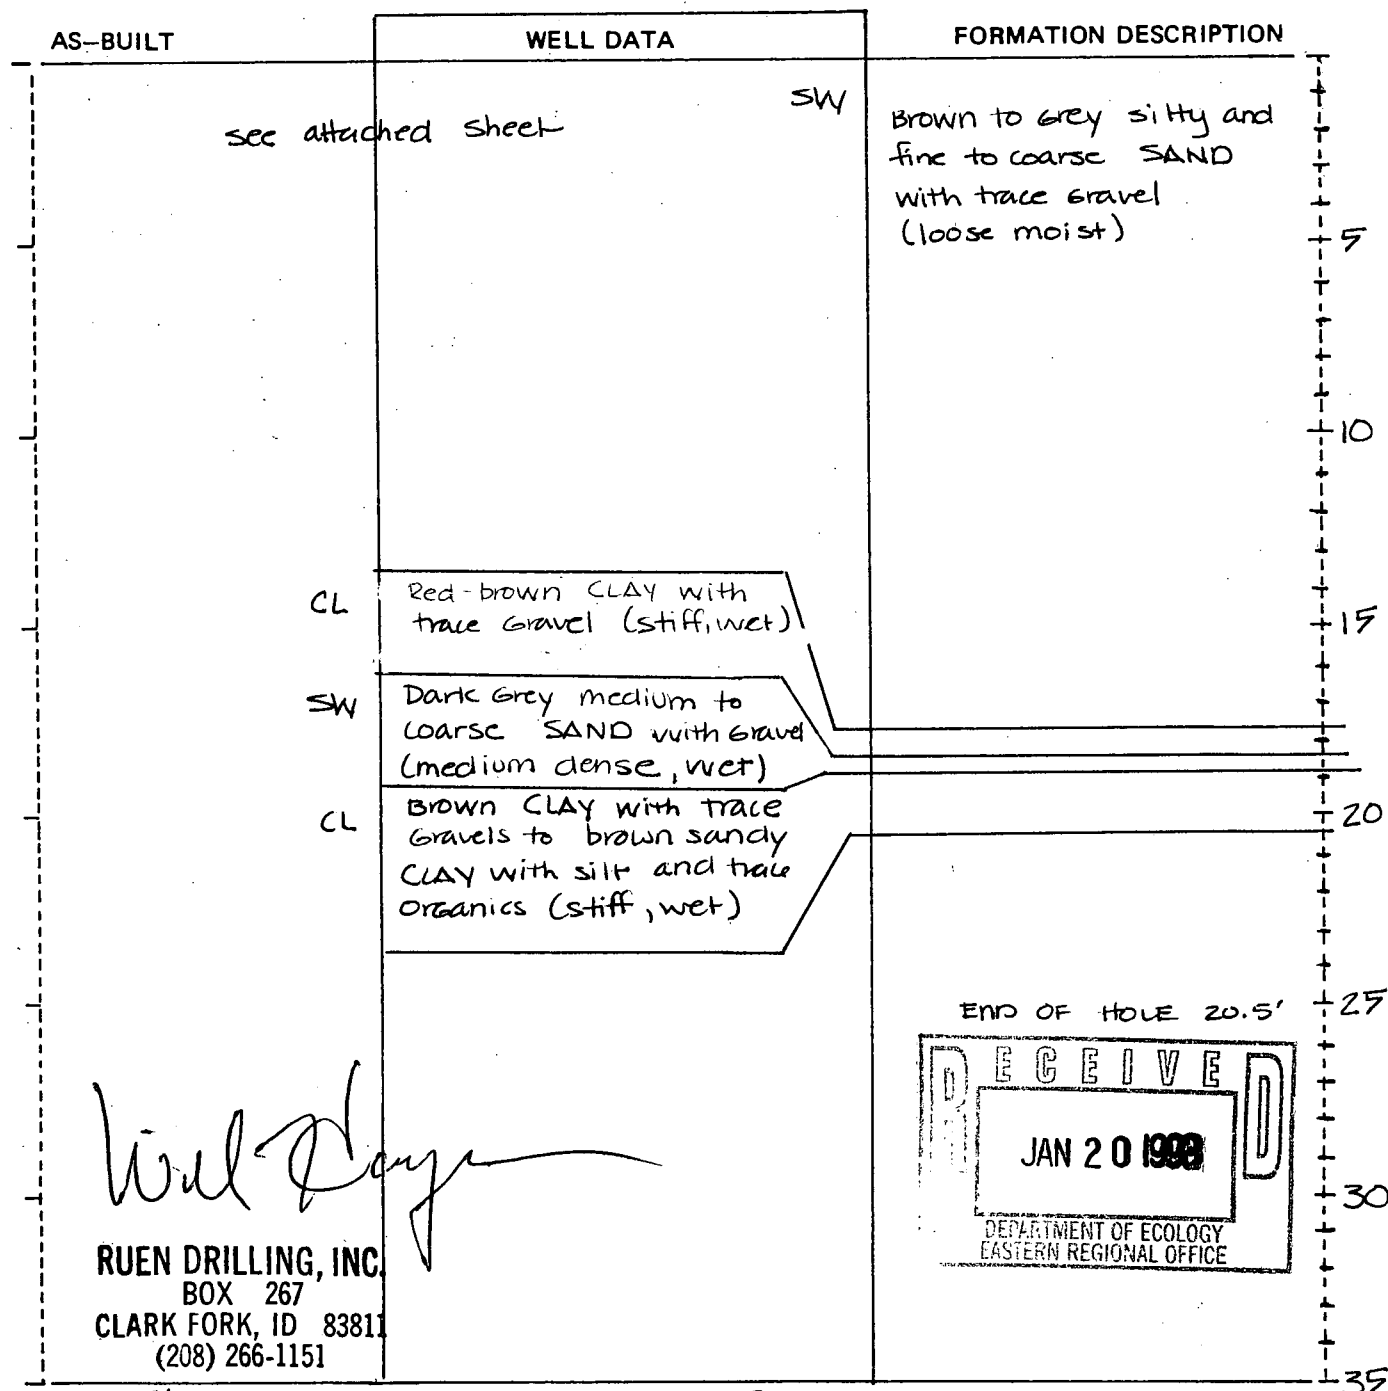SCALE: 1" = 5'PAGE 1 OF 2

LANDAU ASSOCIATES, INC.
Edmonds, WA (206) 778-0907 FAX (206) 778-6409

As-built Well Completion Form

Project: SAS - BURN PIT
Project No.: 207001.33
Well(s) No.: MW 148
Drilling Co.: RUEEN DRILLING INC.
Installation Start Date: 12/21/92 Hour: 1715
Installation Finish Date: 12/21/92 Hour: 1015
Well Type: ☒ Single ☐ Nested ☐ Clustered


120 Monumetal

WATER DISCHARGE MONITORING			
Date:	Time:	PID(ppm)	
Date:	Time:	PID(ppm)	
EQUIPMENT USED	
<input type="checkbox"/>	Hollow Stem Auger
<input type="checkbox"/>	Cable Tool
<input type="checkbox"/>	Air Rotary
<input type="checkbox"/>	Other _____

MATERIALS USED	
<u>15</u>	Sacks of <u>10 - 20</u> Sand
<u>2</u>	Sacks of _____ Concrete/Cement
_____	Sacks of _____ Grout Mix Used
<u>3</u>	Sacks of <u>9</u> Powdered Bentonite <u>Chips</u>
_____	Pounds of Bentonite Pellets/Chips
<u>10</u>	Feet of <u>2</u> Inch PVC Blank Casing
<u>10</u>	Feet of <u>2</u> Inch PVC Slotted Screen
_____	_____
_____	_____

DEVELOPMENT			
Method of Development: <u>BAILER 1 1/2" SS</u>			
Begin Date: <u>12/22/92</u>		Time: <u>20 GALS SLIGHT SLTY</u>	
Finish Date: _____		Time: _____	
Yield:	Time From:	To:	Date:
Estimate of Total Water Removed <u>20</u> During Development: <u>Gallons</u>			
Description of Turbidity at End of Development:		<input type="checkbox"/> Clear <input checked="" type="checkbox"/> Slightly Cloudy <input type="checkbox"/> Mod. Turbid <input type="checkbox"/> Very Cloudy	
Odor of Water: <u>NONE</u>			
Water Discharged To: <u>GROUND</u>			
Depth to Water After Development: <u>18.49</u> TOP PVC <u>Feet</u>			

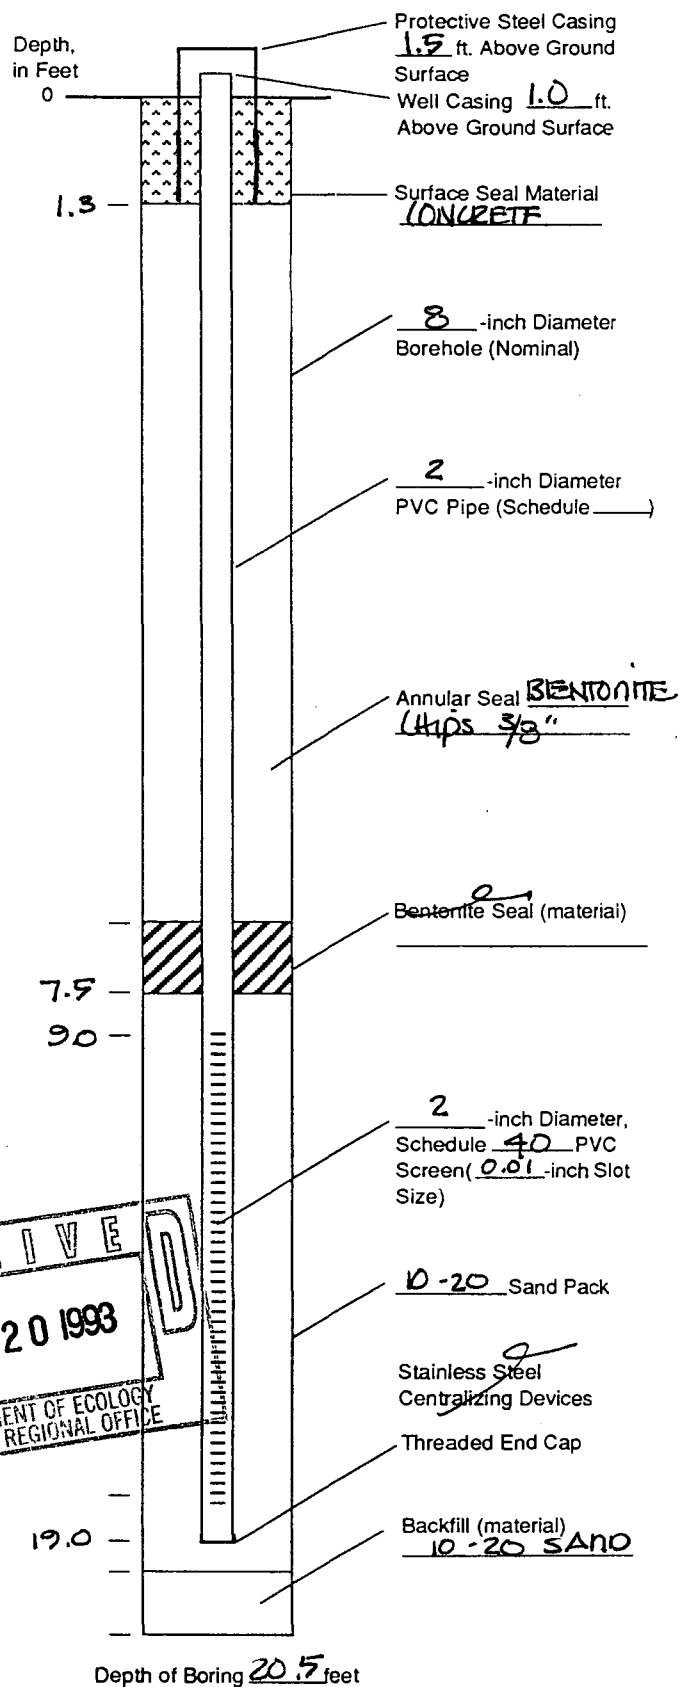


					SES Project Number: 0270-001		Spokane International Airports, New Wells PFOA-PFOS Assessment		Boring Number: MW-18 Well Tag: BKP-261		
					Equipment Type/ model #: Mobile G-2400					Location NAD 83 47.619878 N, -117.517124 W	
					Auger type/diameter: 8-inch Hollow Stem						
					Contractor: Geologic Drill, LLC						
					Sampling method: 2-inch SPT					Sheet 1 of 1	
					Hammer Weight: 140 Lbs					Above-Grade Monument	
					Free Fall: 30"						
					Location of Boring: South of W. Electric Avenue.					Time 1300	
					Surface conditions/ Topsoil Depth: Grass-covered.						
										Date 7/30/18	
					Material Description						
Blow Counts	Recovery %	Depth in Feet	Graphic Log	Soil Graph/ USCS							
		0		GM	Brown silty Gravel with sand. Loose, Dry. With organics.						
		1									
		2									
		3									
		4									
3-7-9	60%	5		GM	Grey- brown silty GRAVEL with sand, Loose, Dry.						
		6									
		7									
		8									
		9									
10-12-15	70%	10		SP	Grey- brown SAND, Loose, Wet. Becomes weathered Basalt						
		11									
		12									
		13									
		14									
		15		Rx	Weathered Basalt. Refusal at 13.0 feet bgs.						
		16									
		17									
		18									
		19									
		20			Completed well depth is 12.0- feet bgs. Well constructed with 5-feet of 20-slot screen.						
		21			Boring Completed at 13.0-feet BGS. Groundwater encountered at 10.0 feet bgs.						

Project: SIA Land Application Study Area
 Project Location: Spokane International Airport
 Project Number: 36310160

Log of Boring MW-8

Sheet 1 of 1

Date(s) Drilled	11/29/12	Logged By	JEL	Checked By	GDP
Drilling Method	Air Rotary	Drilling Contractor	H2O Well Drilling	Total Depth of Borehole	25 feet bgs
Drill Rig Type	Star 30k-DH	Drill Bit Size/Type	6 in. Tubex	Ground Surface Elevation	2370.7 feet bgs
Groundwater Level	2360.75 feet	Sampling Method	Cuttings	Hammer Data	NA
Borehole Backfill	NA	Location	Northing 246693.59, Easting 2447195.34		

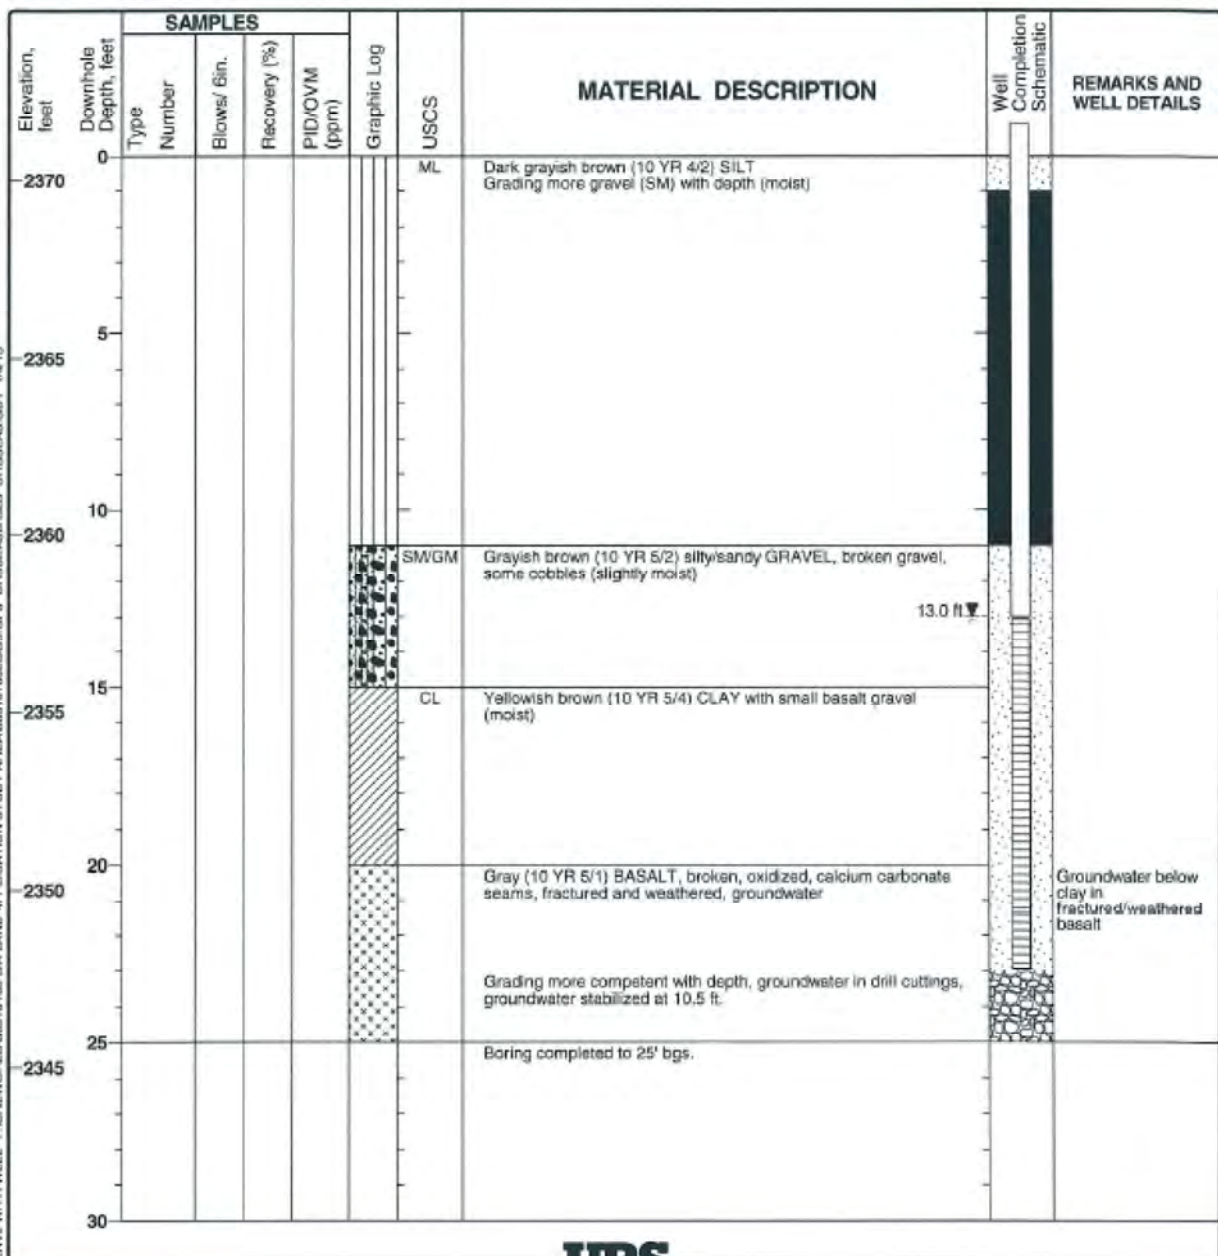


START CARD NO. R06492

PROJECT NAME: ANG-Spokane
 WELL IDENTIFICATION NO. ACD 743 MW-9
 DRILLING METHOD: HEA
 DRILLER: RODNEY LABROSSE
 FIRM: Cascade Drilling, Inc.
 SIGNATURE: [Signature]
 CONSULTING FIRM: ERM WEST
 REPRESENTATIVE: MIKE ARNOLD

COUNTY: SPOKANE
 LOCATION: NW 1/4 NW 1/4 Sec 5 Twp 24N R 42E
 STREET ADDRESS OF WELL: 1 mi West of Electric Ave & Berger Ave
 WATER LEVEL ELEVATION: 7
 GROUND SURFACE ELEVATION: N/A
 INSTALLED: 11-23-96
 DEVELOPED: YES

6558

AS-BUILT	WELL DATA	FORMATION DESCRIPTION
	WELL COVER	0 - 3 ft. <i>Brown silts</i>
	CONCRETE SURFACE SEAL DEPTH = 1/ft	
	PVC BLANK <u>2" x 7'</u> <i>Portland Slurry to 1</i>	3 - 18.5 ft. <i>sandy silts & gravels w/ some cobbles</i>
	BACKFILL <u>ft.</u> TYPE: <u>hant chips to 3</u>	
	PVC SCREEN <u>2" x 10'</u> SLOT SIZE: <u>010</u>	
	GRAVEL PACK <u>to 5' ft.</u> MATERIAL: <u>2/12</u>	
	WELL DEPTH <u>17'</u> <u>18.5</u> <i>↑ sand</i>	

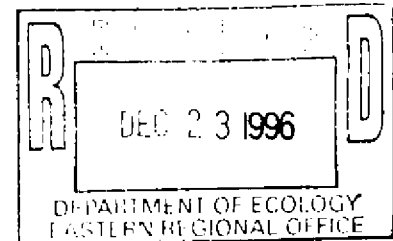

SCALE: 1" = _____

PAGE _____ OF _____

ECY 060-12 (Rev. 11/09)

Project: SIA Land Application Study Area
 Project Location: Spokane International Airport
 Project Number: 36310160

Log of Boring MW-10

Sheet 1 of 1

Date(s) Drilled	11/28/12	Logged By	JEL	Checked By	GDP
Drilling Method	Air Rotaty	Drilling Contractor	H2O Well Drilling	Total Depth of Borehole	25 feet bgs
Drill Rig Type	Star 30k-DH	Drill Bit Size/Type	6 in. Tubex	Ground Surface Elevation	2359.2 feet bgs
Groundwater Level	2351.13 feet	Sampling Method	Cuttings	Hammer Data	NA
Borehole Backfill	NA	Location	Northing 247338.63, Easting 2450941.31		

Elevation, feet	Downhole Depth, feet	SAMPLES				USCS	MATERIAL DESCRIPTION	Well Completion Schematic	REMARKS AND WELL DETAILS
		Type Number	Blows/ 6in.	Recovery (%)	PID/QVM (ppm)				
0	0					ML	Brown (10 YR 5/3) SILT with few angular to subangular basalt gravel (dry to slightly moist)		
2355	5								
2350	10								
2345	15						Gray (10 YR 5/1) BASALT, fractured and weathered (moderately moist)		
2340	20						Grading (10 YR 6/1) to (10 YR 3/1) dependent on dry to wet with yellowish brown (10 YR 3/1) clay in fractures (wet)		
2335	25						Boring completed to 25' bgs.		
2330	30								

ENV2 WITH WELL T:\VNEWORLD\36310160 SIA LAND APPLICATION STUDY AREA\36310160 LOGS.GPJ_URSSEA3B.GLB_URSSEA3.GDT_1/4/13


PROJECT: SIA Land Application Site Monitoring Well Installation				 CASCADE EARTH SCIENCES A Valmont Industries Company		PROJECT NUMBER: 2014230009		MONITORING WELL NUMBER: MW-11			
BORING N246527.94 LOCATION: E2449283.08						LOGGED BY: BJK		CHECKED BY: DRW		PAGE: 1 OF 1	
DRILLED BY: Fogle Pump and Supply						START DATE: 8/21/2014		PERMIT NO. BIO-784			
DRILLING EQUIPMENT: Sandvik T25KW Air Rotary						SAMPLING EQUIPMENT: Cuttings				COMPLETION DATE: 8/23/2014	
WELL CONSTRUCTION DATA (MEASURED FROM TOP OF CASING)											
TOTAL DEPTH: 19'		WELL DEPTH: 19'		BOREHOLE DIA.(IN): 6"		CASING MATERIAL AND DIA. (IN): 2" Schedule 40 PVC		CASING STICK-UP +/-: +2.79'			
FILTER PACK INT. 7'-19' SIZE: 10/20 CSSI SANITARY SEAL INT. 3'-7' TYPE: 3/8" Bentonite chips GROUT INT. None TYPE: None				SURFACE SEAL INT: 0-3' TYPE: Concrete WELL SCREEN INT: 9'-19' SLOT SIZE (IN): 0.020 WATER LEVEL/DATE (MEASURED BELOW T.O.C.) H2O @ 9.3' BGS - 8/21/14 @ 0830							
GROUND SURFACE ELEV. (FT MSL): 2367.8		TOP OF CASING ELEV. (FT MSL): 2370.59		COMMENT:							
GROUP SYMBOL	INTERVAL (FT. B.G.S.)	DESCRIPTION OF LITHOLOGY	DEPTH (FT. B.G.S.)	WELL GRAPHIC	SAMPLE				REMARKS (DRILLING CONDITIONS, PID READINGS, ETC.)		
					BLOW COUNT	RECOVERY	TYPE	NUMBER			
			0						Ground surface		
			2						Start at 0740		
ML	5'	SANDY SILT: Brown (2.5Y 3/3), dry, sand-silt mix, no gravels.	4								
			6								
			8								
	10'	SAND AND GRAVEL: Brown (2.5Y 4/2), damp, poorly graded sand with gravel.	10						Final water level = 9.3' BGS.		
SP			12								
			14						Encountered water at 13' BGS.		
	15'	SILTY SAND: Brown (10Y 2/2), with yellow pockets (10YR 8/8), damp/wet, silty sand with gravels.	16						Driller feel different layer at 15' BGS.		
SM			18						Basalt at 17' BGS.		
Basalt	17'-20'	BASALT: Brown, wet, fractured basalt.	20								
		Total Depth = 20'	22						Terminate drilling at 20' End at 0746		
			24						When 6" casing was removed borehole collapsed a little. 2" schedule 40 pvc casing set to depth of 19' BGS.		
			26								
			28								

THIS SUMMARY APPLIES ONLY AT THE LOCATION OF THIS BORING AND AT THE TIME OF DRILLING. SUBSURFACE CONDITIONS MAY DIFFER AT OTHER LOCATIONS AND MAY CHANGE AT THIS LOCATION WITH THE PASSAGE OF TIME. THE INFORMATION PRESENTED IS A SIMPLIFICATION OF ACTUAL CONDITIONS ENCOUNTERED.

MONITORING WELL CONSTRUCTION DETAILS

PROJECT NAME SIA Land Application Site Monitoring Well Installation BORING/WELL NO. MW-11
PROJECT NUMBER 2014230009 TOP OF CASING ELEV. AT MARK 2370.59
DATE INSTALLED 8/21/2014 GROUND SURFACE ELEV. 2367.8
WELL PERMIT NO. BIO-784 DATUM NAVD88
LOCATION N246527.94, E2449283.08 (Washington State Plane North)
NOTES: _____

WELL SCHEMATIC DRAWING NOT TO SCALE

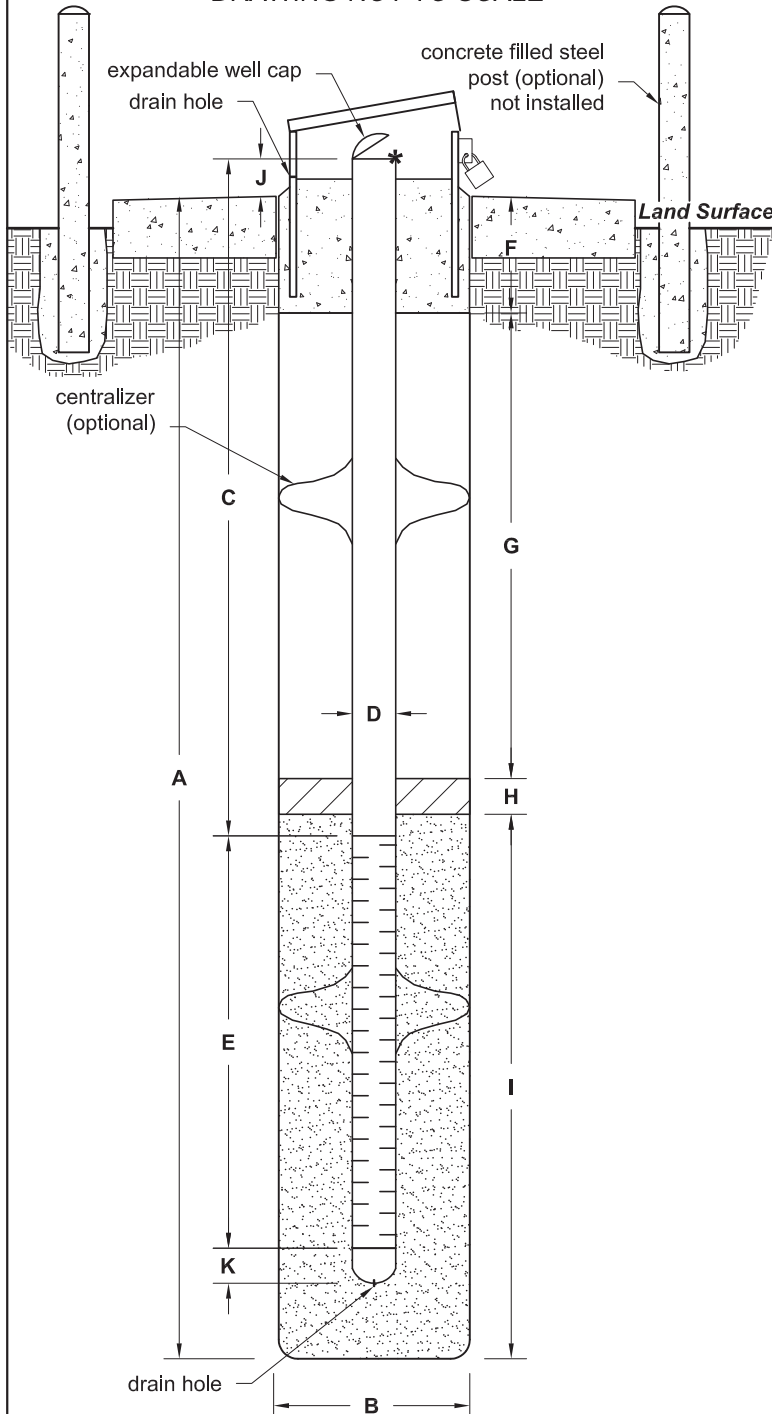

NOTE: Depths and intervals are measured from ground surface.

BORING INFORMATION

A. Total Depth 19 ft.
B. Borehole Diameter 6 in.
Drilling method Sandvik T25KW Air Rotary

WELL CONSTRUCTION

C. Total Casing length 21.79 ft.
Material Schedule 40 PVC
D. Well Casing Diameter (I.D.) 2 in.
E. Well Screen
Screen length 10 ft.
Screen interval from 9 ft. to 19 ft.
Slot size 0.020 in.
F. Surface Seal from 0 ft. to 3 ft.
Seal materials Concrete
G. Grout from - ft. to - ft.
Grout material -
H. Bentonite Sanitary Seal from 3 ft. to 9 ft.
Seal materials 3/8" Bentonite Chips
I. Filter Pack from 7 ft. to 19 ft.
Pack material 10/20 CSSI sand
J. Well Casing height (above grade) 2.79 ft.
K. Well Sump length 0 ft.
Well tail piece length 3 in.
Centralizers located at 9 ft.

NOTES: _____

PROJECT: SIA Land Application Site Monitoring Well Installation		 CASCADE EARTH SCIENCES A Valmont Industries Company		PROJECT NUMBER: 2014230009	MONITORING WELL NUMBER: MW-12
BORING N249177.19 LOCATION: E2450041.46				LOGGED BY: BJK	CHECKED BY: DRW
DRILLED BY: Fogle Pump and Supply				START DATE: 8/21/2014	COMPLETION DATE: 8/23/2014
DRILLING EQUIPMENT: Sandvik T25KW Air Rotary				SAMPLING EQUIPMENT: Cuttings	
WELL CONSTRUCTION DATA (MEASURED FROM TOP OF CASING)					
TOTAL DEPTH: 26'	WELL DEPTH: 26'	BOREHOLE DIA.(IN): 6"	CASING MATERIAL AND DIA. (IN): 2" Schedule 40 PVC	CASING STICK-UP +/-: +2.65'	
FILTER PACK INT. 5'-26' SIZE: 10/20 CSSI		SURFACE SEAL INT: 0-3' TYPE: Concrete			
SANITARY SEAL INT. 3'-5' TYPE: 3/8" Bentonite chips		WELL SCREEN INT: 6'-26' SLOT SIZE (IN): 0.020			
GROUT INT. None TYPE: None		WATER LEVEL/DATE (MEASURED BELOW T.O.C.): h2o @ 11.15' BGS - 8/21/14 @ 1120			
GROUND SURFACE ELEV. (FT MSL): 2349.8		TOP OF CASING ELEV. (FT MSL): 2352.45		COMMENT:	

GROUP SYMBOL	INTERVAL (FT. B.G.S.)	DESCRIPTION OF LITHOLOGY	DEPTH (FT. B.G.S.)	WELL GRAPHIC	SAMPLE				REMARKS (DRILLING CONDITIONS, PID READINGS, ETC.)
					BLOW COUNT	RECOVERY	TYPE	NUMBER	
GW			0						Ground surface
			2						Start at 0740
	5'	SANDY GRAVEL: Brown, dry, well graded sands and gravels with fine silt.	4	3/8" BENTONITE CHIPS					
	10'	SANDY GRAVEL: Brown, dry, well graded sands and gravels with fine silt.	10	10/20 CSSI SAND					Final water level = 10.7' BGS
	13'-17'	BOULDER	12						Basalt at 13' BGS. Pause drilling at 0917 to cut 6" casing so driller can advance head. Drilling resumed at 0933.
ML	17'	SANDY SILT: Brown (2.5Y 3/3), with orange (10YR 5/8), and gray (Gley1 4/10GY) lenses and gravels, damp, sandy silt.	18						
	20'	SANDY SILT: Brown, wet, sandy silt with gravels.	20						Encountered water at 20' BGS.
Basalt	23'	BASALT: wet, fractured basalt.	22						Basalt at 23' BGS.
	Total Depth = 26'		26						Terminate drilling at 26' End at 0945

THIS SUMMARY APPLIES ONLY AT THE LOCATION OF THIS BORING AND AT THE TIME OF DRILLING. SUBSURFACE CONDITIONS MAY DIFFER AT OTHER LOCATIONS AND MAY CHANGE AT THIS LOCATION WITH THE PASSAGE OF TIME. THE INFORMATION PRESENTED IS A SIMPLIFICATION OF ACTUAL CONDITIONS ENCOUNTERED.

MONITORING WELL CONSTRUCTION DETAILS

PROJECT NAME SIA Land Application Site Monitoring Well Installation

BORING/WELL NO.

MW-12

PROJECT NUMBER 2014230009

TOP OF CASING ELEV. AT MARK

2352.45

DATE INSTALLED 8/21/2014

GROUND SURFACE ELEV.

2349.8


WELL PERMIT NO. BIO-785

DATUM NAVD88

LOCATION N249177.19, E2450041.46 (Washington State Plane North)

NOTES:

WELL SCHEMATIC
DRAWING NOT TO SCALE

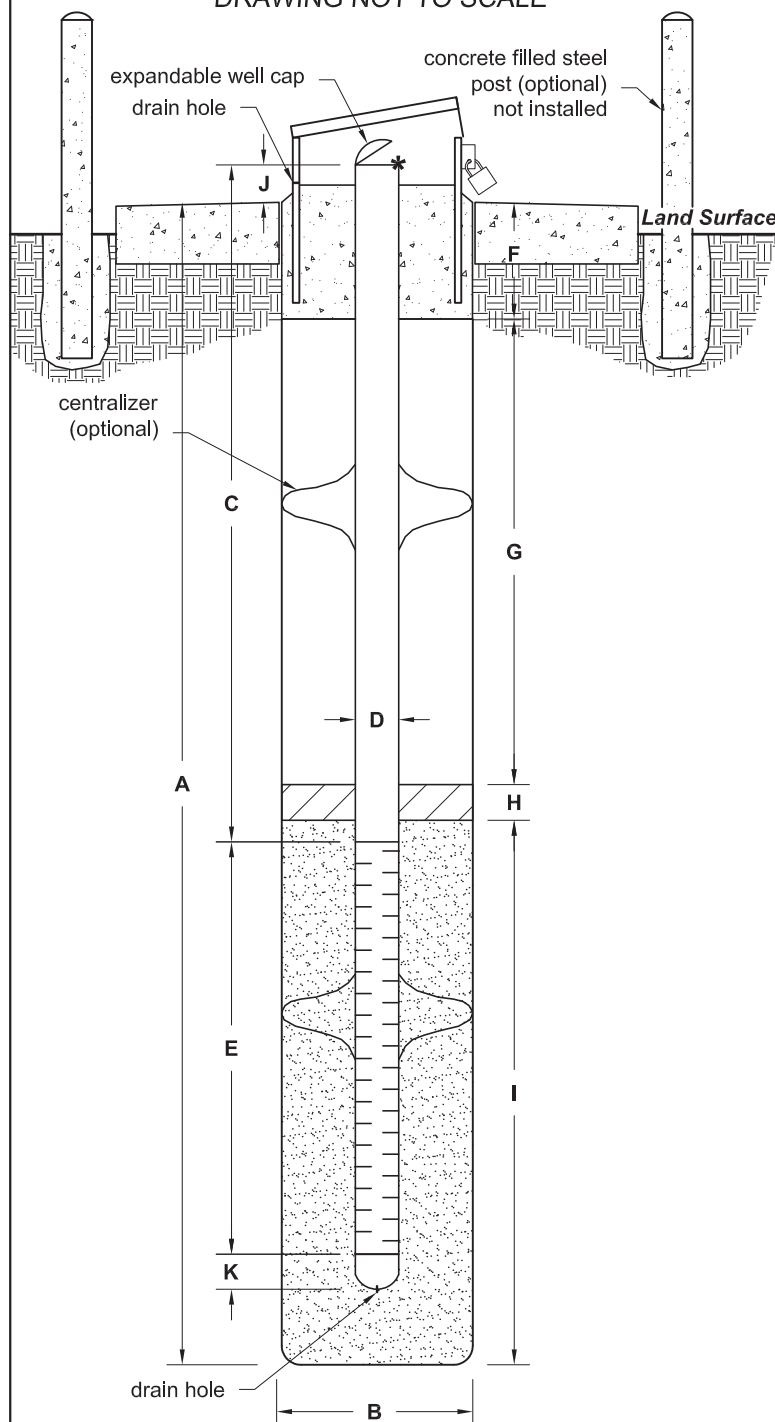

NOTE: Depths and intervals are measured from ground surface.

BORING INFORMATION

A. Total Depth 26 ft.

B. Borehole Diameter 6 in.

Drilling method Sandvik T25KW Air Rotary

WELL CONSTRUCTION

C. Total Casing length 28.65 ft.

Material Schedule 40 PVC

D. Well Casing Diameter (I.D.) 2 in.

E. Well Screen

Screen length 20 ft.

Screen interval from 6 ft. to 26 ft.

Slot size 0.020 in.

F. Surface Seal from 0 ft. to 3 ft.

Seal materials Concrete

G. Grout from _____ ft. to _____ ft.

Grout material

H. Bentonite Sanitary Seal from 3 ft. to 5 ft.

Seal materials 3/8" Bentonite Chips

I. Filter Pack from 5 ft. to 26 ft.

Pack material	10/20 CSSI sand
---------------	-----------------

J. Well Casing height (above grade) 2.65 ft.

K. Well Sump length 0 ft.

Well tail piece length 3 in.

Centralizers located at 11 and 21 ft.

NOTES: -

ECOVA Corporation							Well Number <u>MW-1A</u>	
Well Installation Log							Date Drilled <u>5-10-90</u>	
Client - <u>Army Corps of Engineers</u>			Drilling Company <u>Fogle Pump & Supply</u>		Coordinates <u>246670.5625N</u>			
Site <u>SP Site (Task 6)</u>			Boring Method <u>Air Rotary</u>		Coordinates <u>2460128.4101E</u>			
Job Number <u>801126</u>			Borehole Depth <u>83 Feet</u>		Casing Elevation <u>2319.00'</u>			
Field Geologist <u>R.M. Weber</u>			Water Depth <u>13 Feet</u>		Sheet <u>1 of 2</u>			
Depth (Feet)	Blow Counts	Sample No.	Recover	Organic Vapor (ppm)	% LEL	% O ₂	General: 50 feet 6" steel casing, pressure grout.	Graphic Log
							Sample Description	
5							SILTY SAND (SM) - Fine- to coarse-grained sand, brown, with black basalt cuttings, damp.	
10							BASALT - Fresh, light gray, dry.	
15							Basalt - Fresh, dark gray, dry. Hard drilling.	
							Static water level at 13 Feet.	
20							BASALT - Alternating light and dark gray, dry.	
25							Dry, hard drilling.	
30							BASALT - Gray, with white and orange fragments, easier drilling, damp.	
35							WEATHERED BASALT - Same as above with minor clay, sand, and gravel.	
40							Water yielding zone at 40 feet.	
45							BASALT - Fractured, weathered, orange and white fragments, some clays, sand and gravel.	
50							BASALT - Dark gray.	

1990 ECOVA Corporation

801126-A-MW1A

* Background = 0 ppm

100
5 1091